AS-BUILT DRAWING

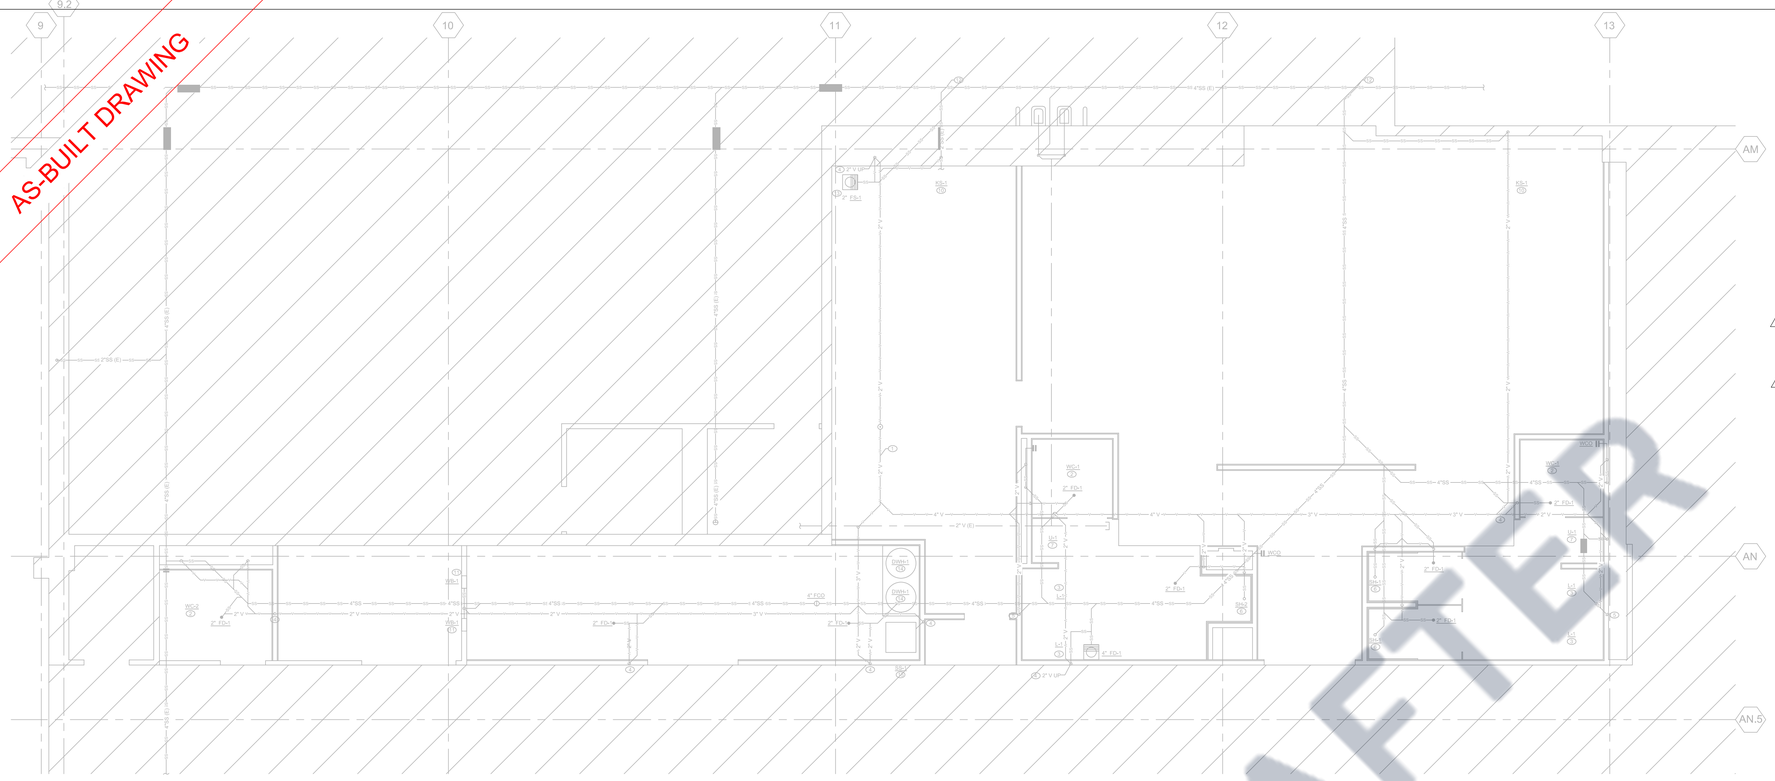

2 PLUMBING ENLARGED PLAN - GROUND LEVEL
1/4" = 1'-0"

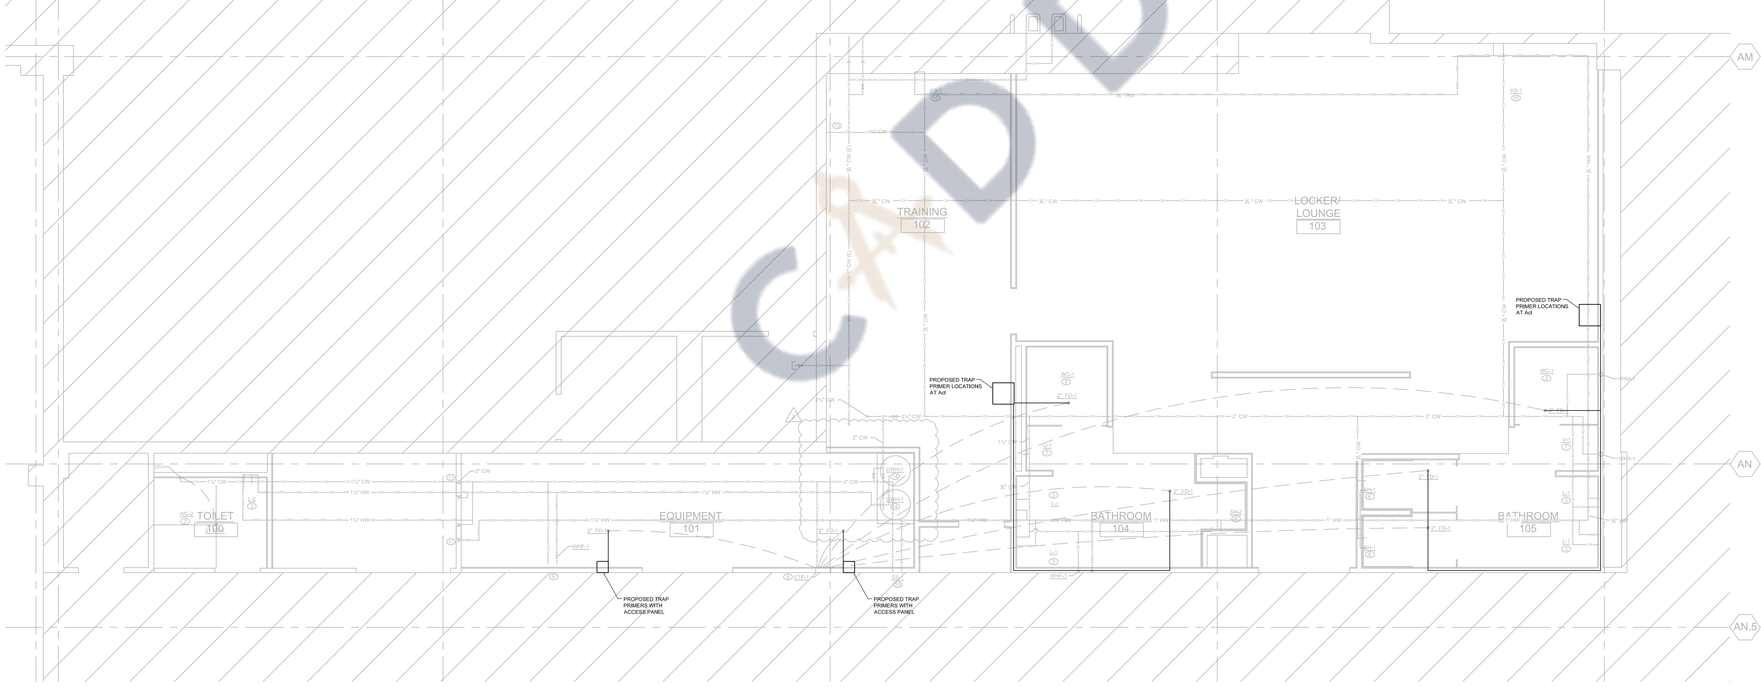

1 PLUMBING ENLARGED PLAN - GROUND LEVEL
1/4" = 1'-0"

WORK NOTES
(THIS SHEET ONLY)

1. 4" V THRU ROOF OFFSET ON LEVEL 2, MAINTAIN 3'-0" FROM WALLS AND 10'-0" FROM OUTSIDE AIR INTAKE.
2. 1" CW TO WATER CLOSETF LUSH VALVE.
3. 1/2" CW/HW TO LAV 2" SS AND 2" V CONNECTIONS TO LAVATORY L-2.
4. 2" V UP FROM BELOW.
5. 2" SS DOWN, 2" V UP FROM BELOW SLAB. ROUTE MINIMUM 6" ABOVE FLOOD ROM OF FIXTURE BEING SERVED PRIOR TO OFFSETTING AND COMBINING HORIZONTALLY.
6. 1/2" CW/HW TO SHOWER.
7. 3/4" TO URINAL FLUSH VALVE.
8. 3/4" CW WITH ISOLATION VALVE TO ELECTRONIC TRAP PRIMER, ETP-1 ROUTE 1/2" COPPER PRIMER LINES TO EACH FLOOR DRAIN.
9. 1/2" CW/HW TO WALL HOSE FAUCET, WHF-1.
10. 1/2" CW/HW TO KITCHEN SINK.
11. 3/4" CW/HW TO WASHER WALL BOX, WB-1.
12. POINT OF CONNECTION TO EXISTING SANATORY SEWER. FIELD VERIFY TO EXACT SIZE AND LOCATION PRIOR TO COMMENCING WORK.
13. 1/2" CW TO ICE MACHINE WATER FILTER, BY OTHERS.

2
14. DOMESTIC WATER HEATER MOUNTED ON WALL WITH MANUFACTURE'S BRACKET, PROVIDE CALCULATION PUMP AND EXPANSION TANK. 1/2" CW, HW, GAS AND DRAIN CONNECTIONS, 3" PVC SCH. 40 INTAKE AND EXHAUST DUCT REQUIRED, REFER TO DIAGRAM 1/P6.00.0.

A
15. 3/4" CW/HW TO SERICE SINK.
16. PROVIDE GAS COCK AND PRV. SET PRV TO MATCH EQUIPMENT IT SERVES, APPROXIMATELY 10" W.C. ROUTE PRV VENT TO ATMOSPHERE.

No.	Description	Date

MAIN CONTRACTOR:

SHF International LLC

OFFICE: (+1) 702-388-0961
info@shfcontracting.com
SHF INTERNATIONAL, LLC
6000 S EASTERN AVE 14-H
LAS VEGAS NV 89119

SUB CONTRACTOR:

RED MESA MECHANICAL

LICENSE NUMBER : NV #0086266 - & #0087531

AS-BUILT DATE: 11 September, 2023

SIGN: _____

NOTES:

City of Henderson
Multigen

2821 W.Horizon Ridge PKWY
Suite #200 Henderson,
NV 89052 (702) 269-6060

PLUMBING ENLARGED PLAN -GROUNG LEVEL

RFI NUMBER	RFI #025 TRAP PRIMERS
Project Number	23033
Date	14 September, 2023
Drawn By	SA
Checked By	SM

M6.00.0

Scale	1/4" = 1'-0"

14 September, 2023

CAD DRAFTER